



NOTE
Refer 599 "Material List" for
more descriptions

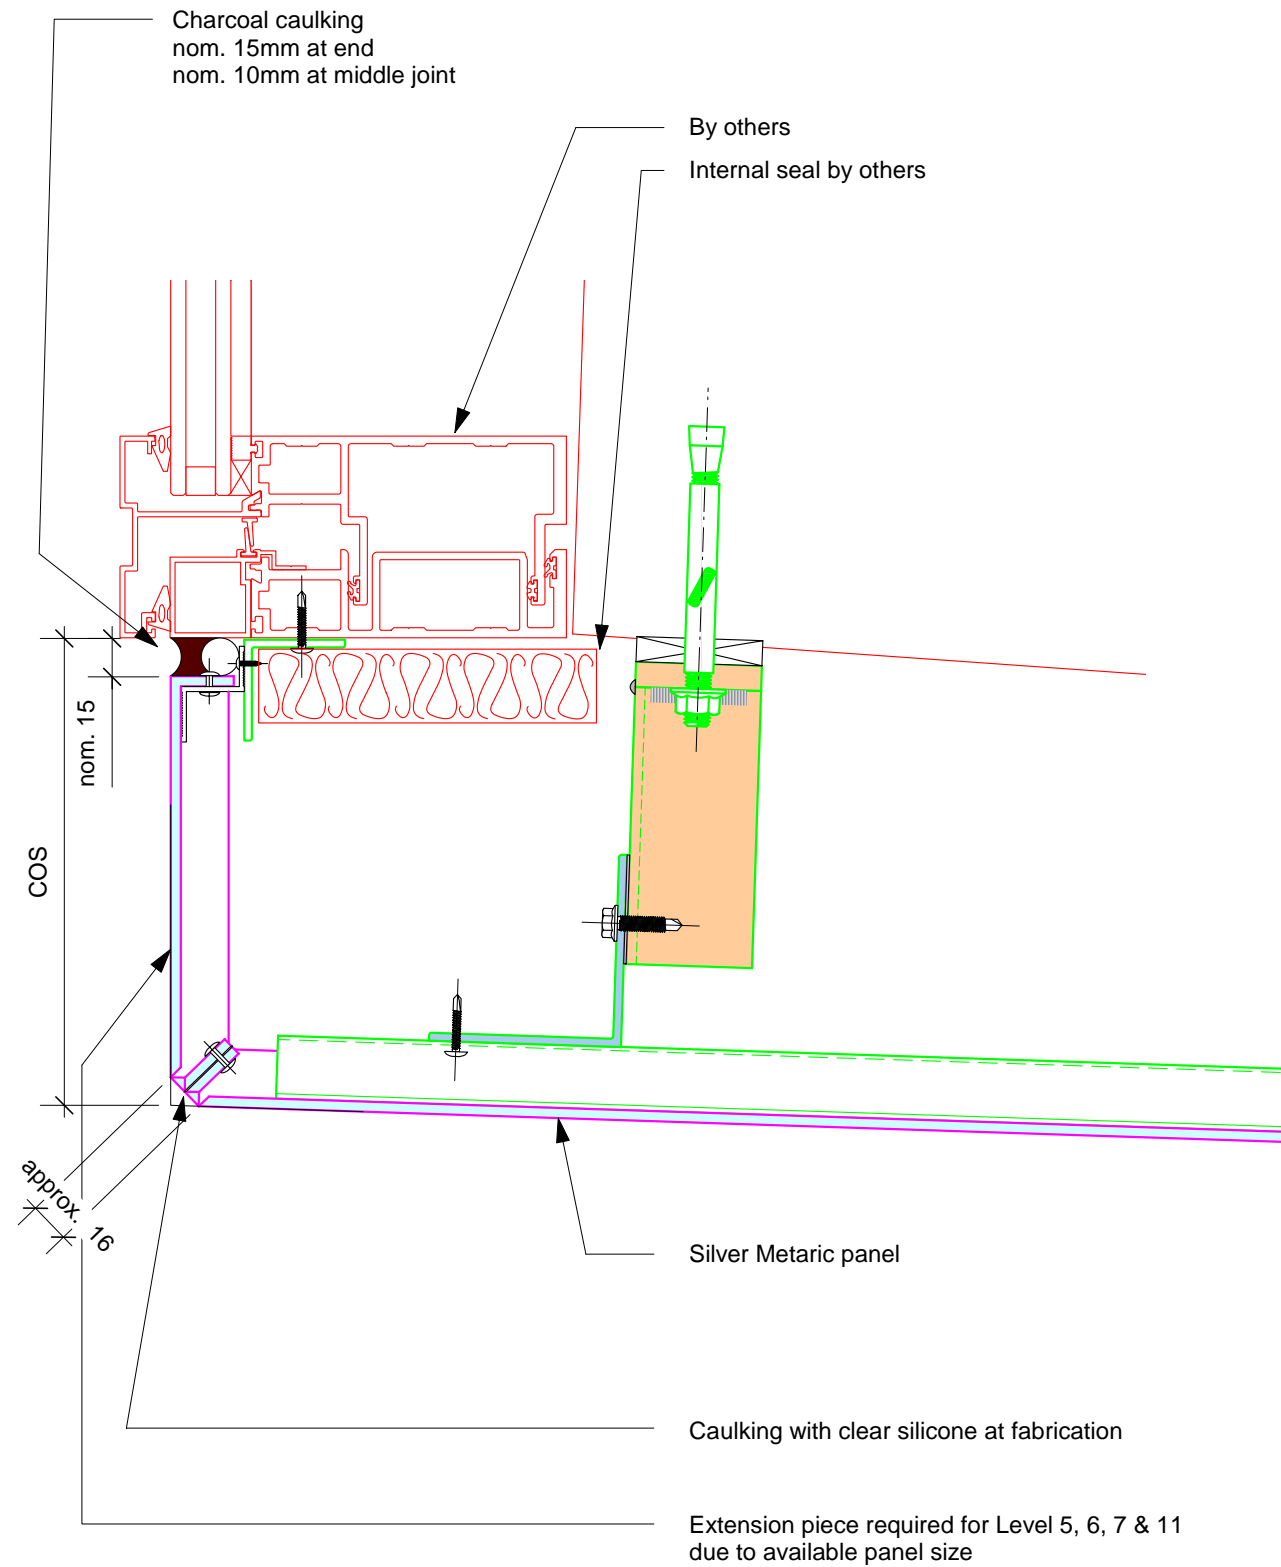

21 PLAN DETAIL
Level 5, 6, 7 & 11

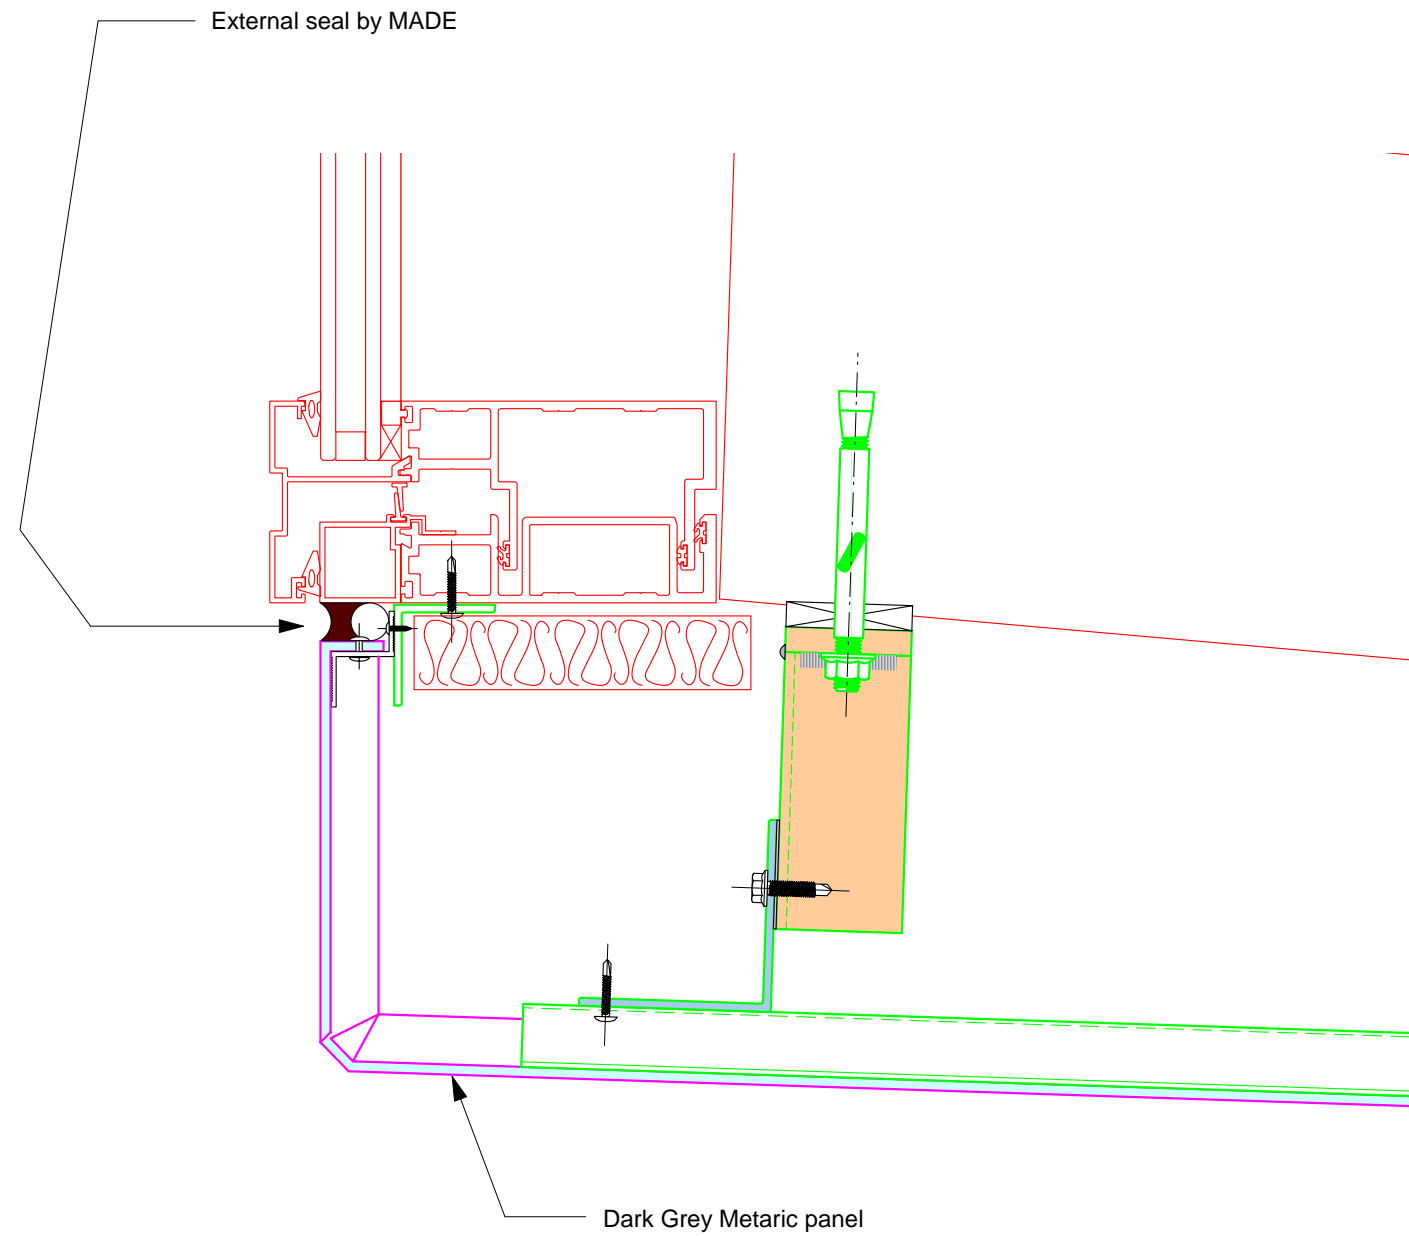

22 PLAN DETAIL
Level 2, 3, 4, 8, 9 & 10

ISSUE	DATE	REVISION
Use figured dimensions in preference to scale. All dimensions to be verified and checked on site.		
Project		
Westfield Sydney City Zone 1 Northwall Cladding		
Fabricator		
MADE CONTRACTING Architectural Fabrications & Installations		
PO BOX 52 SEAFORTH NSW 2092 FAX: 9949 7122 PH: 9948 7861 email: made@alpha.net.au email: jon@made.com.au		
Copyright © 2002 (Made Contracting) All rights reserved		
Drawn		
Masato F.		
Builder		
Architect		
Level		
Drawing Title		
CLADDING CORNER PLAN DETAIL		
Scale:	1:3.	Checked:
Date:	29.04.09	
Job Number:	****	A3
Drawing Status		
AS BUILT		
Drawing No.	MAC-100M-WNC-505	Revision
		AB